


LONGITUDINAL CUT RESTORATION

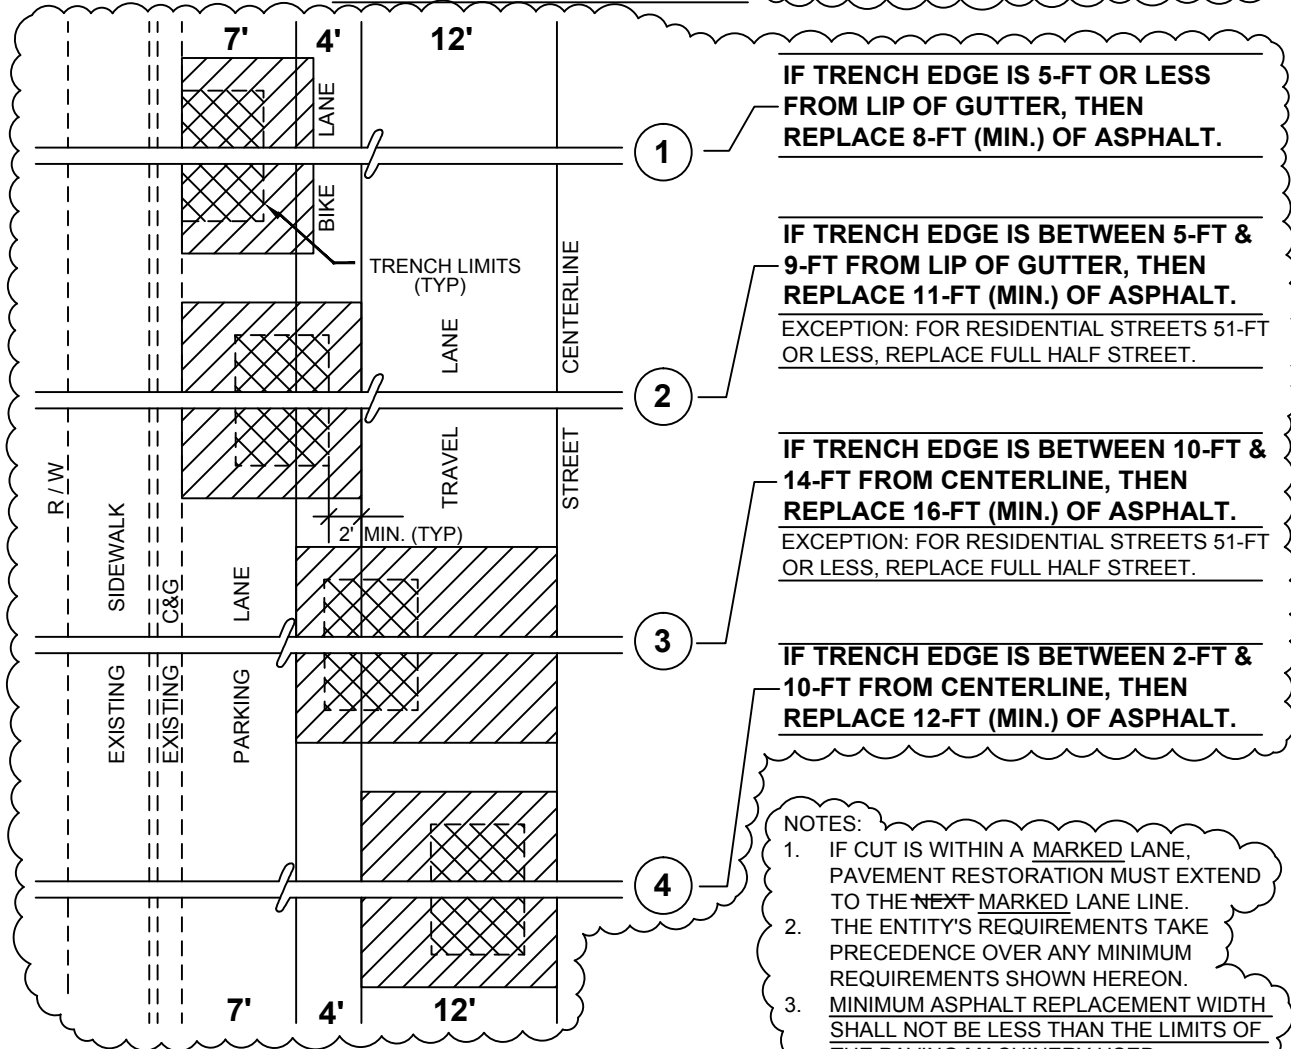

PLAN VIEW

SPECIFICATION REFERENCE	
302	AGGREGATE BASE
401	BITUMINOUS PAVEMENT
406	PRIME COAT
407	FOG SEAL
501	CONCRETE

AGENCY APPROVED						
B	C	H	L	M	N	
UNIFORM STANDARD DRAWINGS CLARK COUNTY AREA						
OVER 5 YEARS PAVEMENT RESTORATION LONGITUDINAL CUT 60 FT. RIGHT-OF-WAY OR LESS						
DATE 6-12-08		DWG. NO. 500BL2- 500.4				