


**ARTERIAL WITH
MEDIAN ISLAND**

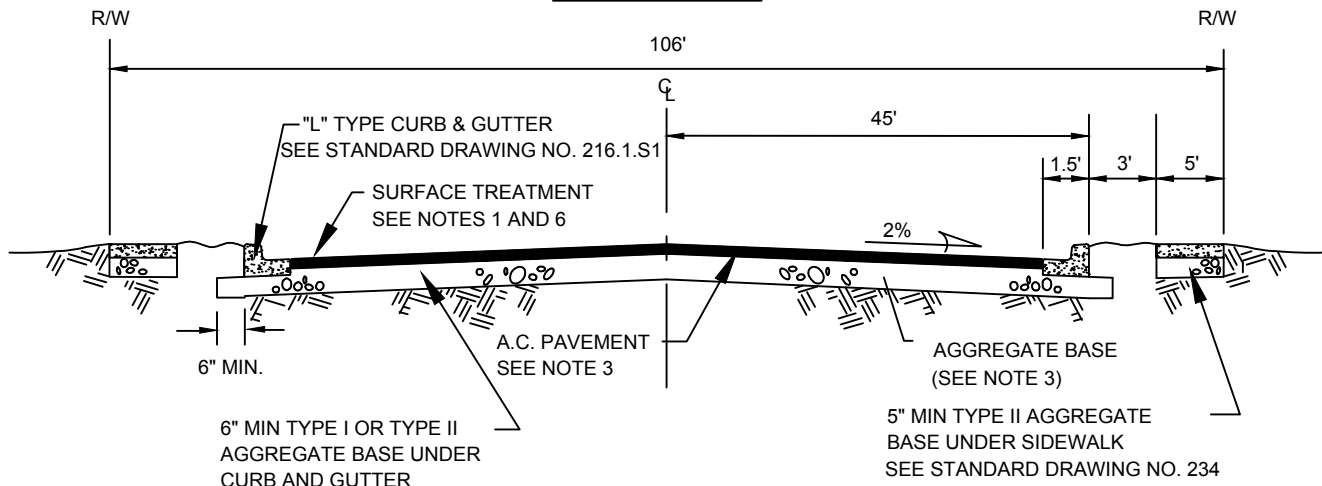

**ARTERIAL WITHOUT
MEDIAN ISLAND**

NOTES:

1. FINAL A.C. PAVEMENT SURFACE (INCLUDING UTACS OR OPEN GRADE) SHALL BE 3/4" MAXIMUM ABOVE LIP OF GUTTER. PAVEMENT SHALL BE FLUSH WITH LIP AT SIDEWALK RAMPS.
2. DENSE GRADE SHALL BE FLUSH WITH LIP OF GUTTER.
3. STRUCTURAL SECTION SHALL BE IN ACCORDANCE WITH STANDARD SPECIFICATION SECTION 401 AND STANDARD DRAWING NO. 200.
4. THIS STANDARD IS AN ALTERNATE STREET SECTION TO BE USED AT LOCATIONS DETERMINED BY EACH LOCAL JURISDICITON. NO ABOVE GROUND OBJECTS SHALL BE PLACED WITHIN THE 5 FOOT SIDEWALK.
5. UNDERGROUND DRY UTILITIES SHALL BE PLACED IN A UTILITY CORRIDOR UNDER THE SIDEWALK.
6. OVERLAY 1" UTACS UNLESS OTHERWISE REQUIRED BY THE ENTITY.

		AGENCY APPROVED				L	
SPECIFICATION REFERENCE		UNIFORM STANDARD DRAWINGS CLARK COUNTY AREA					
302	AGGREGATE BASE	SUPPLEMENTAL DRAWING					
401	BITUMINOUS PAVEMENT	PRIMARY ARTERIAL					
403	OPEN GRADE	COMPLETE STREET ALTERNATIVE					
501	CONCRETE	DATE 07-01/12 DWG. NO. 203.1.S1					

NEW DRAWING

Effective 7/11/12