


**RESIDENTIAL TWO-WAY LOCAL OR CUL-DE-SAC
(LOTS 40' WIDE OR LESS)**

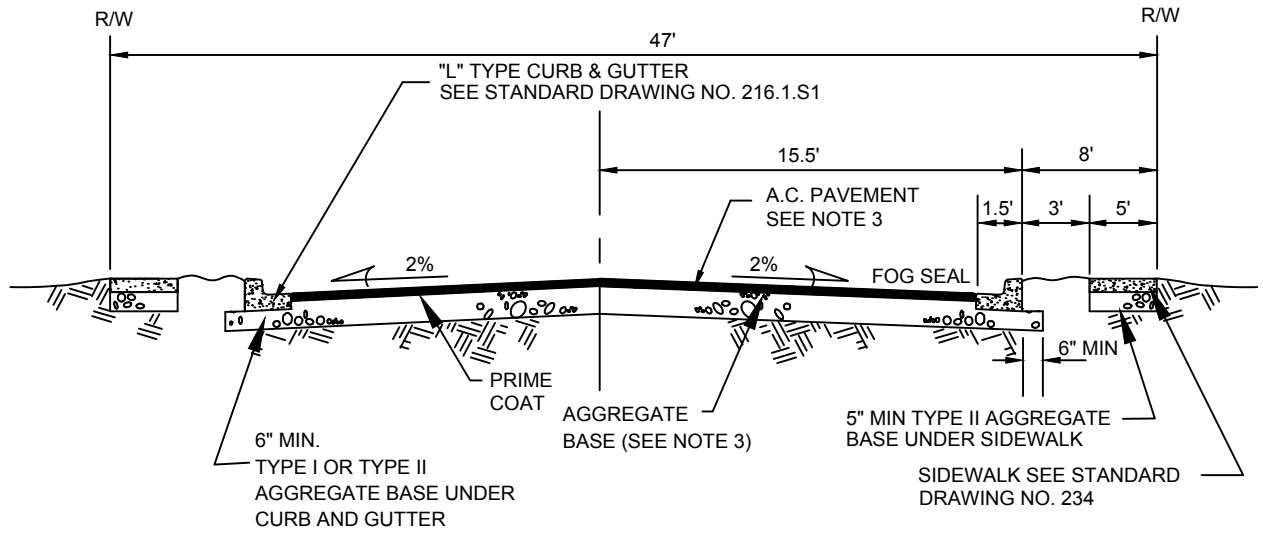

**RESIDENTIAL TWO-WAY LOCAL OR CUL-DE-SAC
(LOTS GREATER THAN 40' WIDE - SEE NOTE 3)**

NOTES:

1. FINAL A.C. PAVEMENT SURFACE SHALL BE 1/4" MAXIMUM ABOVE LIP OF GUTTER. PAVEMENT SHALL BE FLUSH WITH LIP AT SIDEWALK RAMPS.
2. STRUCTURAL SECTION SHALL BE IN ACCORDANCE WITH STANDARD SPECIFICATION SECTION 401 AND STANDARD DRAWING NO. 200.1.
3. HOMES ADJACENT TO THIS STREET SECTION MAY REQUIRE SPRINKLERS PER ENTITY FIRE CODE.

SPECIFICATION REFERENCE		AGENCY APPROVED				
		L				
302		UNIFORM STANDARD DRAWINGS CLARK COUNTY AREA SUPPLEMENTAL DRAWING LOCAL RESIDENTIAL COMPLETE STREET ALTERNATIVES				
401						
406						
407						
501						
		DATE 07-01-12	DWG. NO.	206.1.S1		

NEW DRAWING