


106 FT. STREET

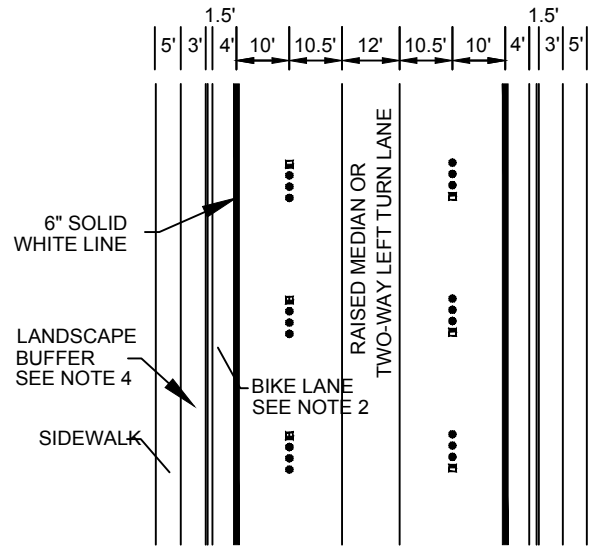

80 FT. STREET

NOTES:

1. LANE LINE DELINEATION SHALL COMPLY WITH STANDARD DRAWING NO. 244 & 244.1.
2. BIKE LANES TO BE PROVIDED IF SEGMENT CONNECTS TO OTHER BIKE LANES OR IF ROADWAY SEGMENT IS 1 MILE OR GREATER. IF BIKE LANE IS NOT PROVIDED, TRAVEL LANES SHOULD REMAIN AT DIMENSIONS SHOWN SO A BICYCLE LANE COULD BE PROVIDED IN THE FUTURE. SEE DRAWING NUMBER 246.1 FOR BIKE LANE SIGNING AND STRIPING DETAILS.
3. ALL CURB LANES ARE MEASURED TO LIP OF GUTTER OR EDGE OF PAVEMENT IF CURB AND GUTTER DO NOT EXIST.
4. CONTACT THE LOCAL JURISDICTIONAL FOR DEVELOPMENT REQUIREMENTS FOR THE AREA BETWEEN THE CURB AND SIDEWALK.

AGENCY APPROVED					L		
SPECIFICATION REFERENCE		UNIFORM STANDARD DRAWINGS CLARK COUNTY AREA					
628	PAINTING TRAFFIC STRIPING	SUPPLEMENTAL DRAWING					
633	PAVEMENT MARKERS	TYPICAL DELINEATION FOR ROADWAYS					
		COMPLETE STREET ALTERNATIVE					
		DATE	07-01-12	DWG. NO.	244.6.S1		

NEW DRAWING